

SKETCH OF "AS BUILT" SEPTIC COMPONENTS

WEST TISBURY, MA

PREPARED FOR

LINDA BASSETT

JULY 28, 2000

SCALE 1/4" = 20 FT

VINEYARD LAND SURVEYING, INC.

P.O. BOX 421 #12 COURNOYER ROAD

WEST TISBURY, MA 02575


508-693-3774

FAX 508-693-8575

ASSR. 32-90

BENCHMARK  
SPIKE IN POLE  
ELEV. = 37.2  
NGVD 1929 DATUM


MARGRETTIC MAY 16, 2000

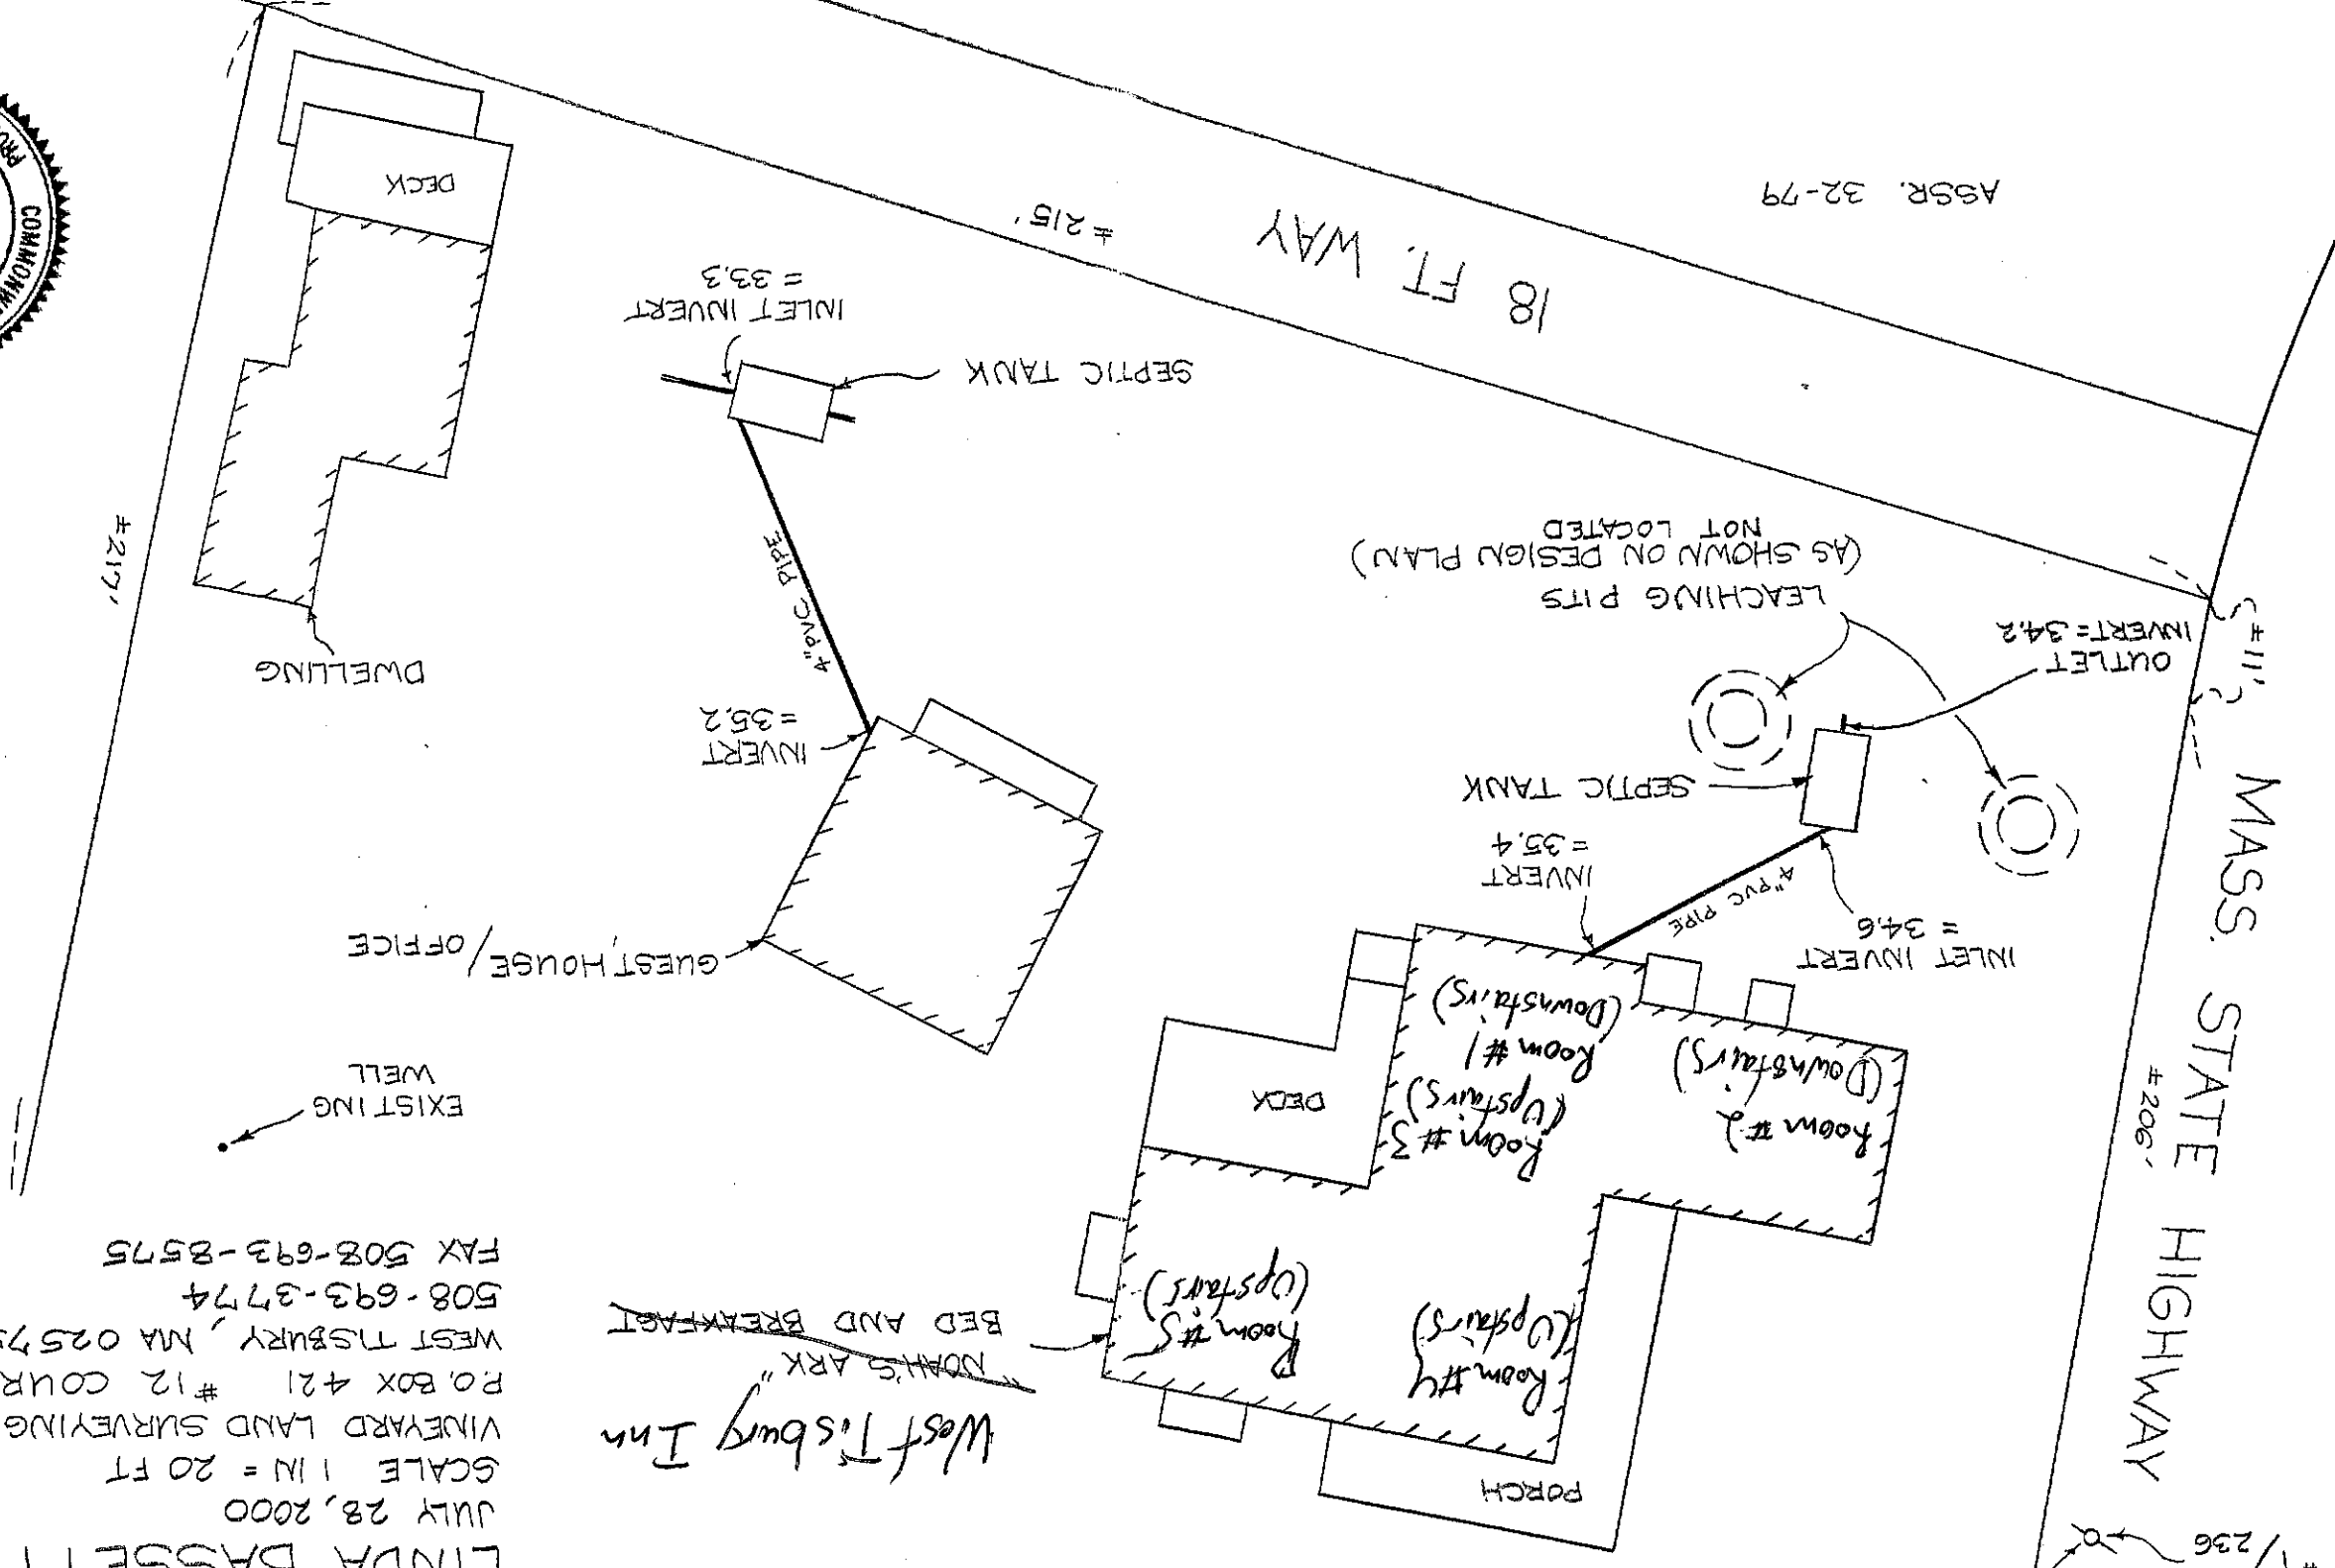

ASSR. 32-79

18 FT. WAY

MASS. STATE HIGHWAY

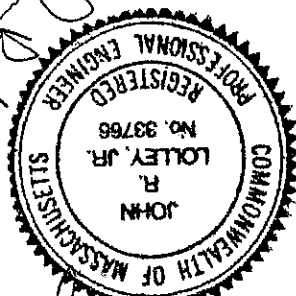

Received  
8/23/00

ASSR. 32-89

JOB 649