
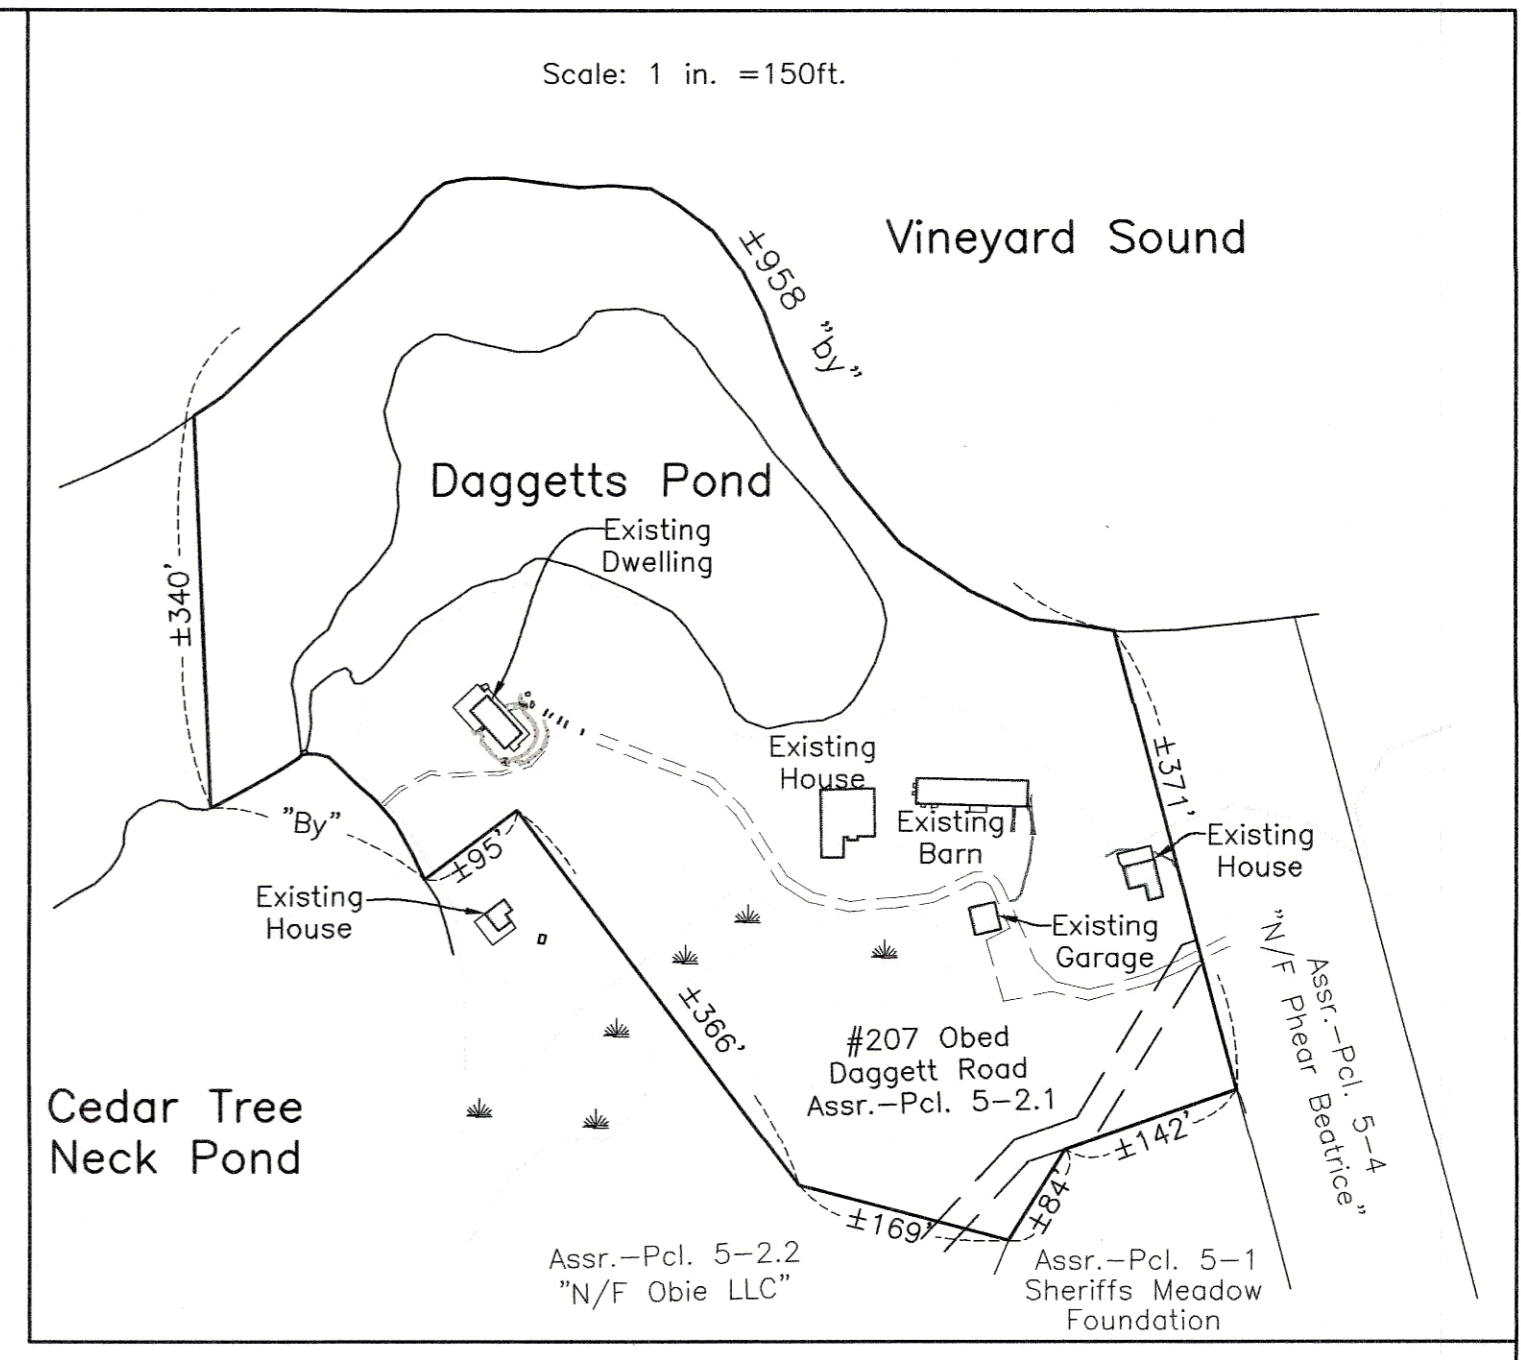
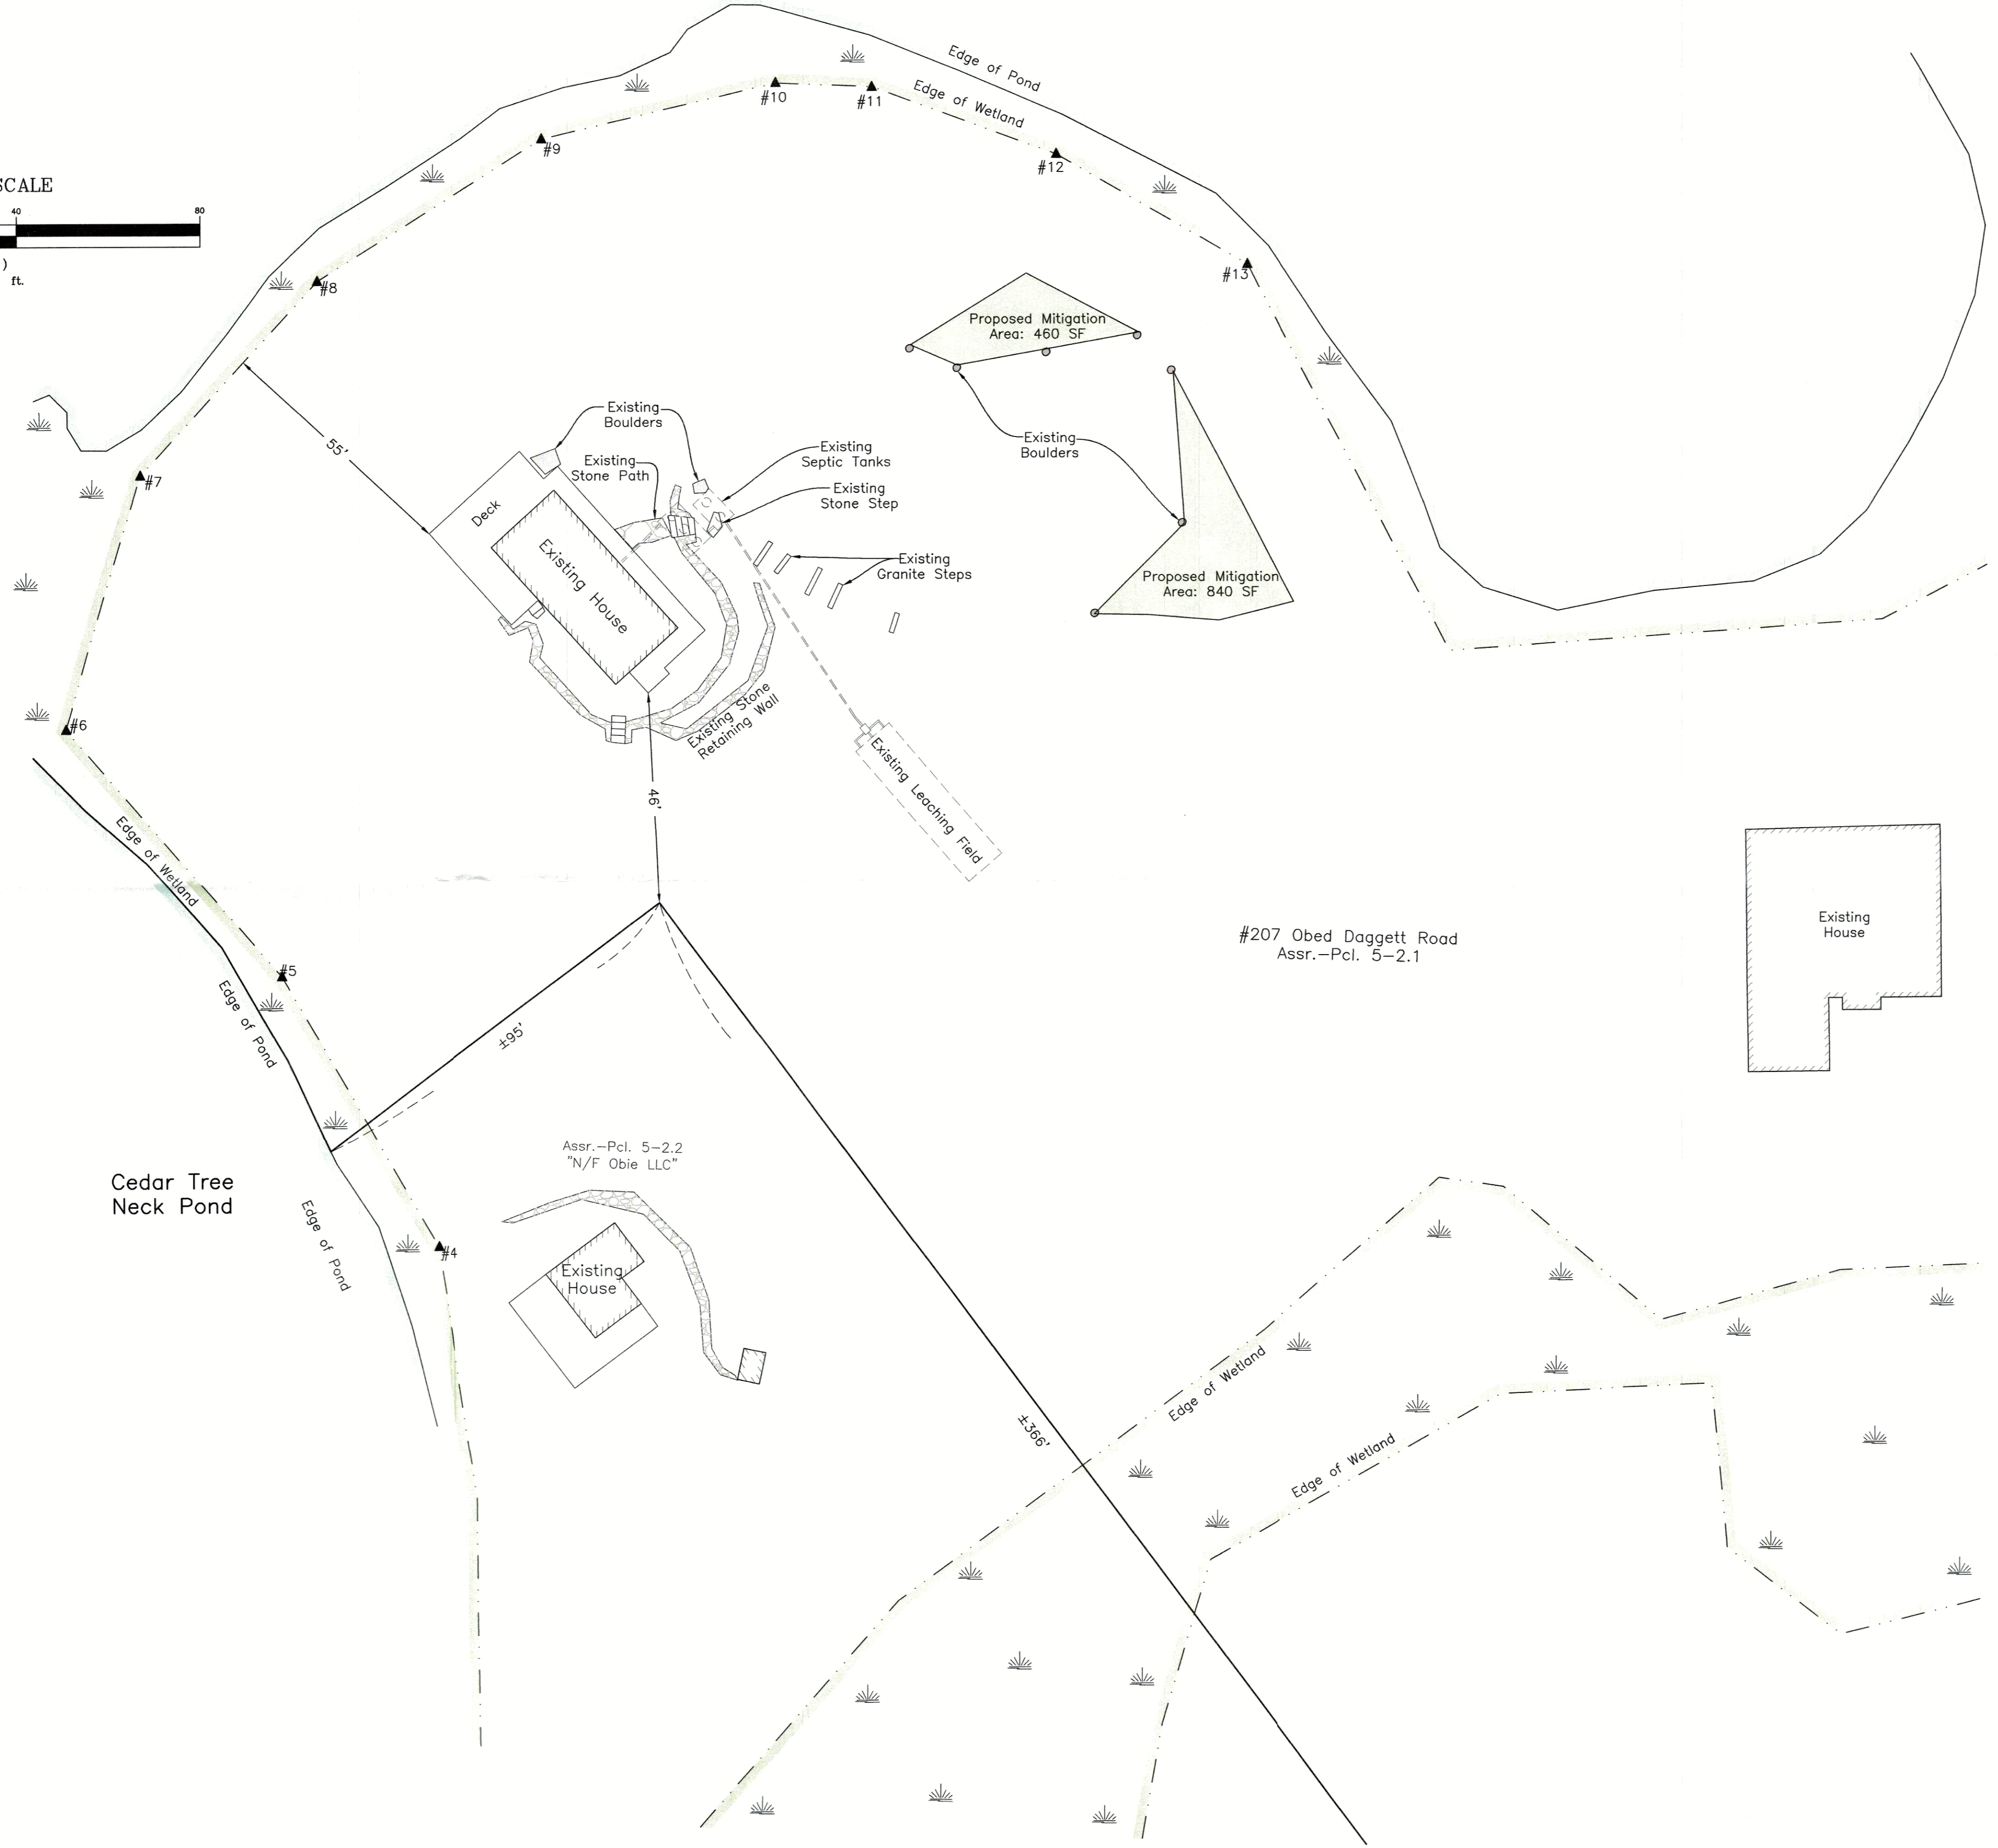



Daggetts Pond

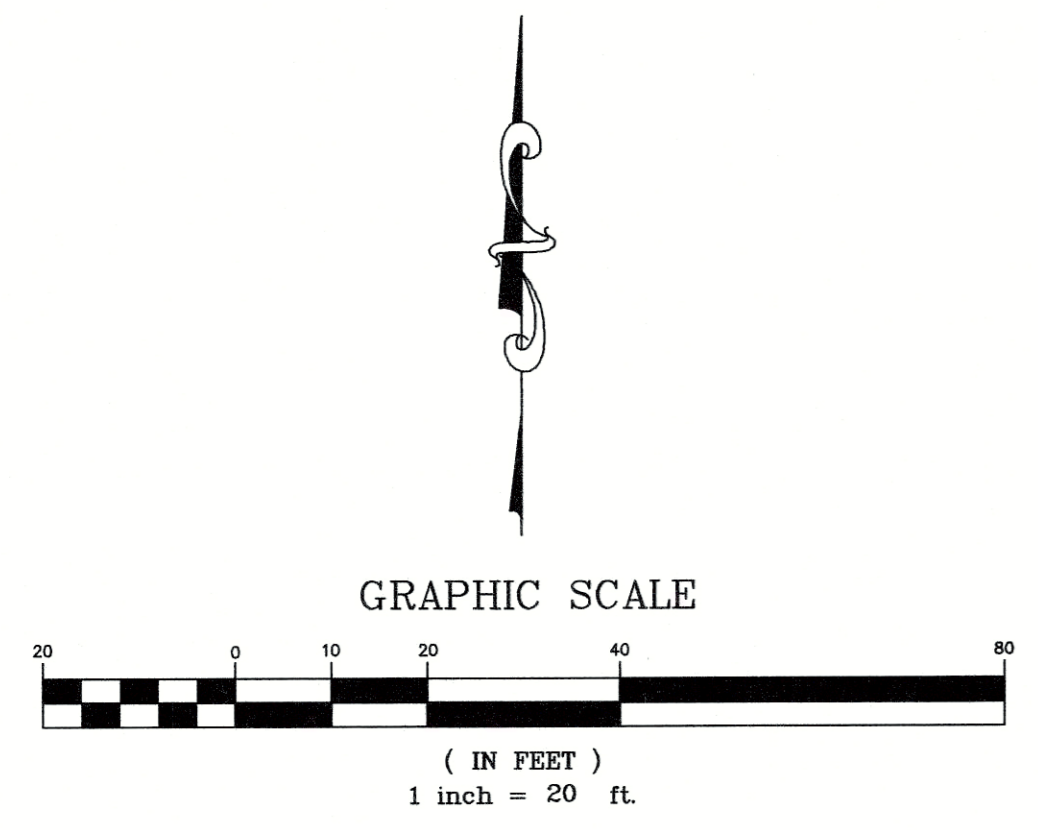

#207 Obed Daggett Road
Assr.-Pcl. 5-2.1

Assr.-Pcl. 5-2.2
"N/F Obie LLC"

Cedar Tree Neck Pond

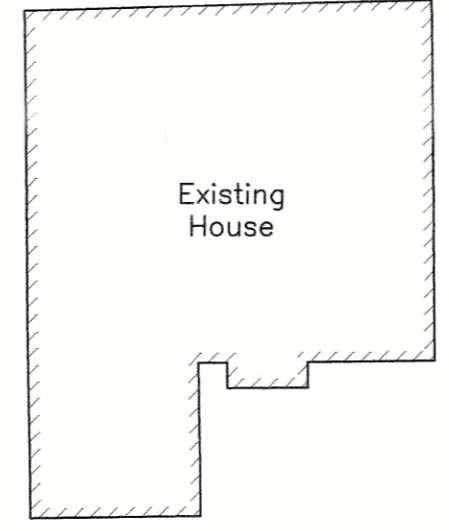

GLENN F. PROVOST
No. 51983
07-22-22

"As-Built"
Site Plan in
West Tisbury, Mass.
Prepared for
Cedar Tree Neck Farm LLC
Scale 1" = 20' July 21, 2022

VINEYARD
LAND SURVEYING
& ENGINEERING

12 Courmoyer Road
P.O. Box 421
West Tisbury, MA 02575
P 508-693-3774 F 508-629-0440
VLSE.net