
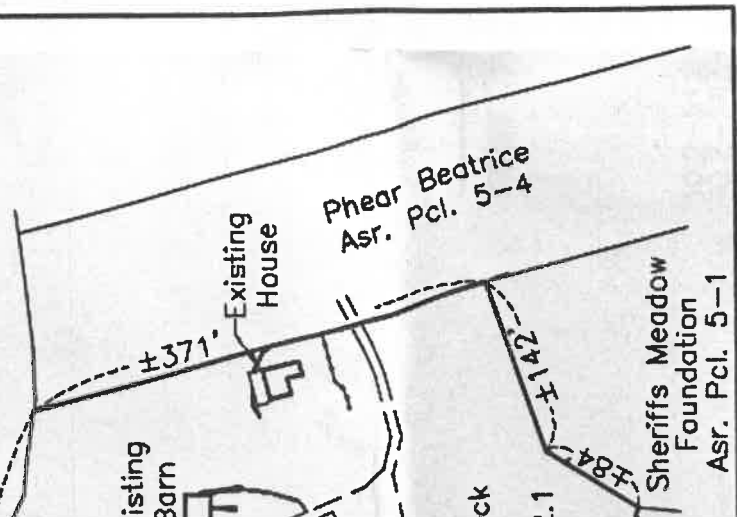


# Daggetts Pond

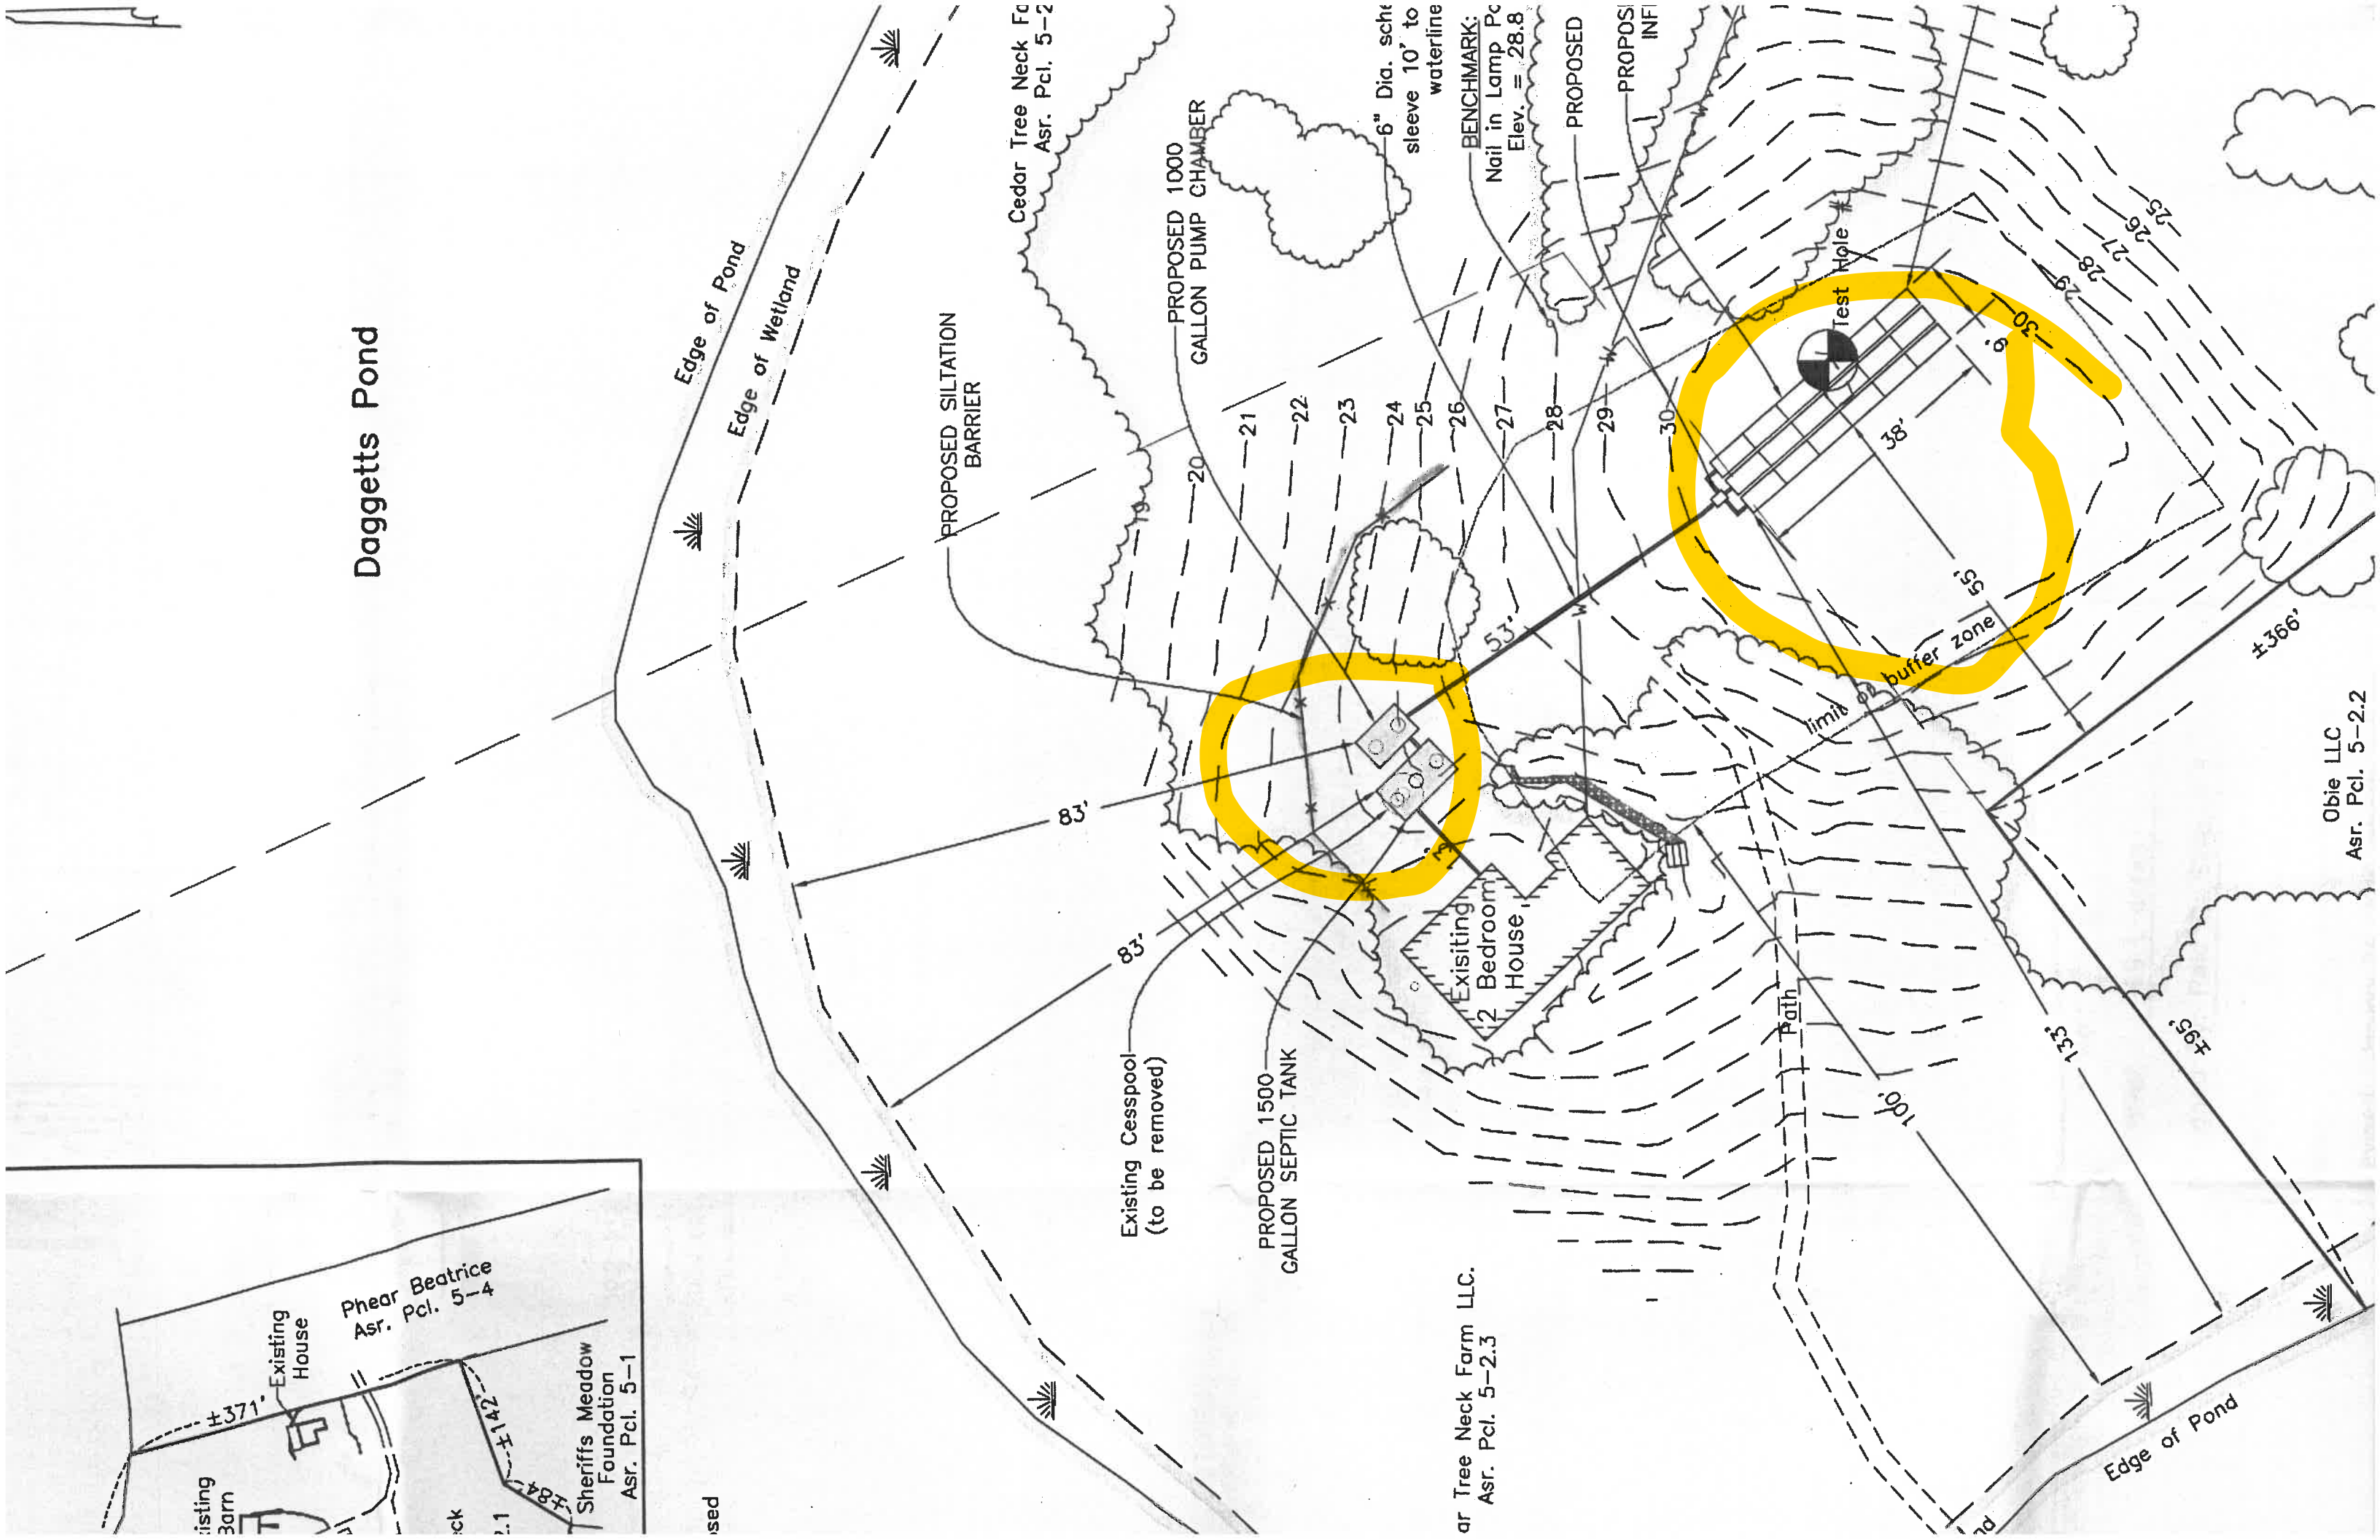

Cedar Tree Neck Farm LLC.  
Asr. Pcl. 5-2.3

Obie LLC  
Asr. Pcl. 5-2.2