

SKETCH OF "AS BUILT" SEPTIC COMPONENTS

WEST TISBURY, MA

PREPARED FOR

LINDA BASSETT

JULY 28, 2000

SCALE 1/4" = 20 FT

VINEYARD LAND SURVEYING, INC.

P.O. BOX 421 #12 COURNOYER ROAD

WEST TISBURY, MA 02575


508-693-3774

FAX 508-693-8575

ASSR. 32-90


BENCHMARK
SPIKE IN POLE
ELEV. = 37.2
NGVD 1929 DATUM

MARGRETTIC MAY 16, 2000

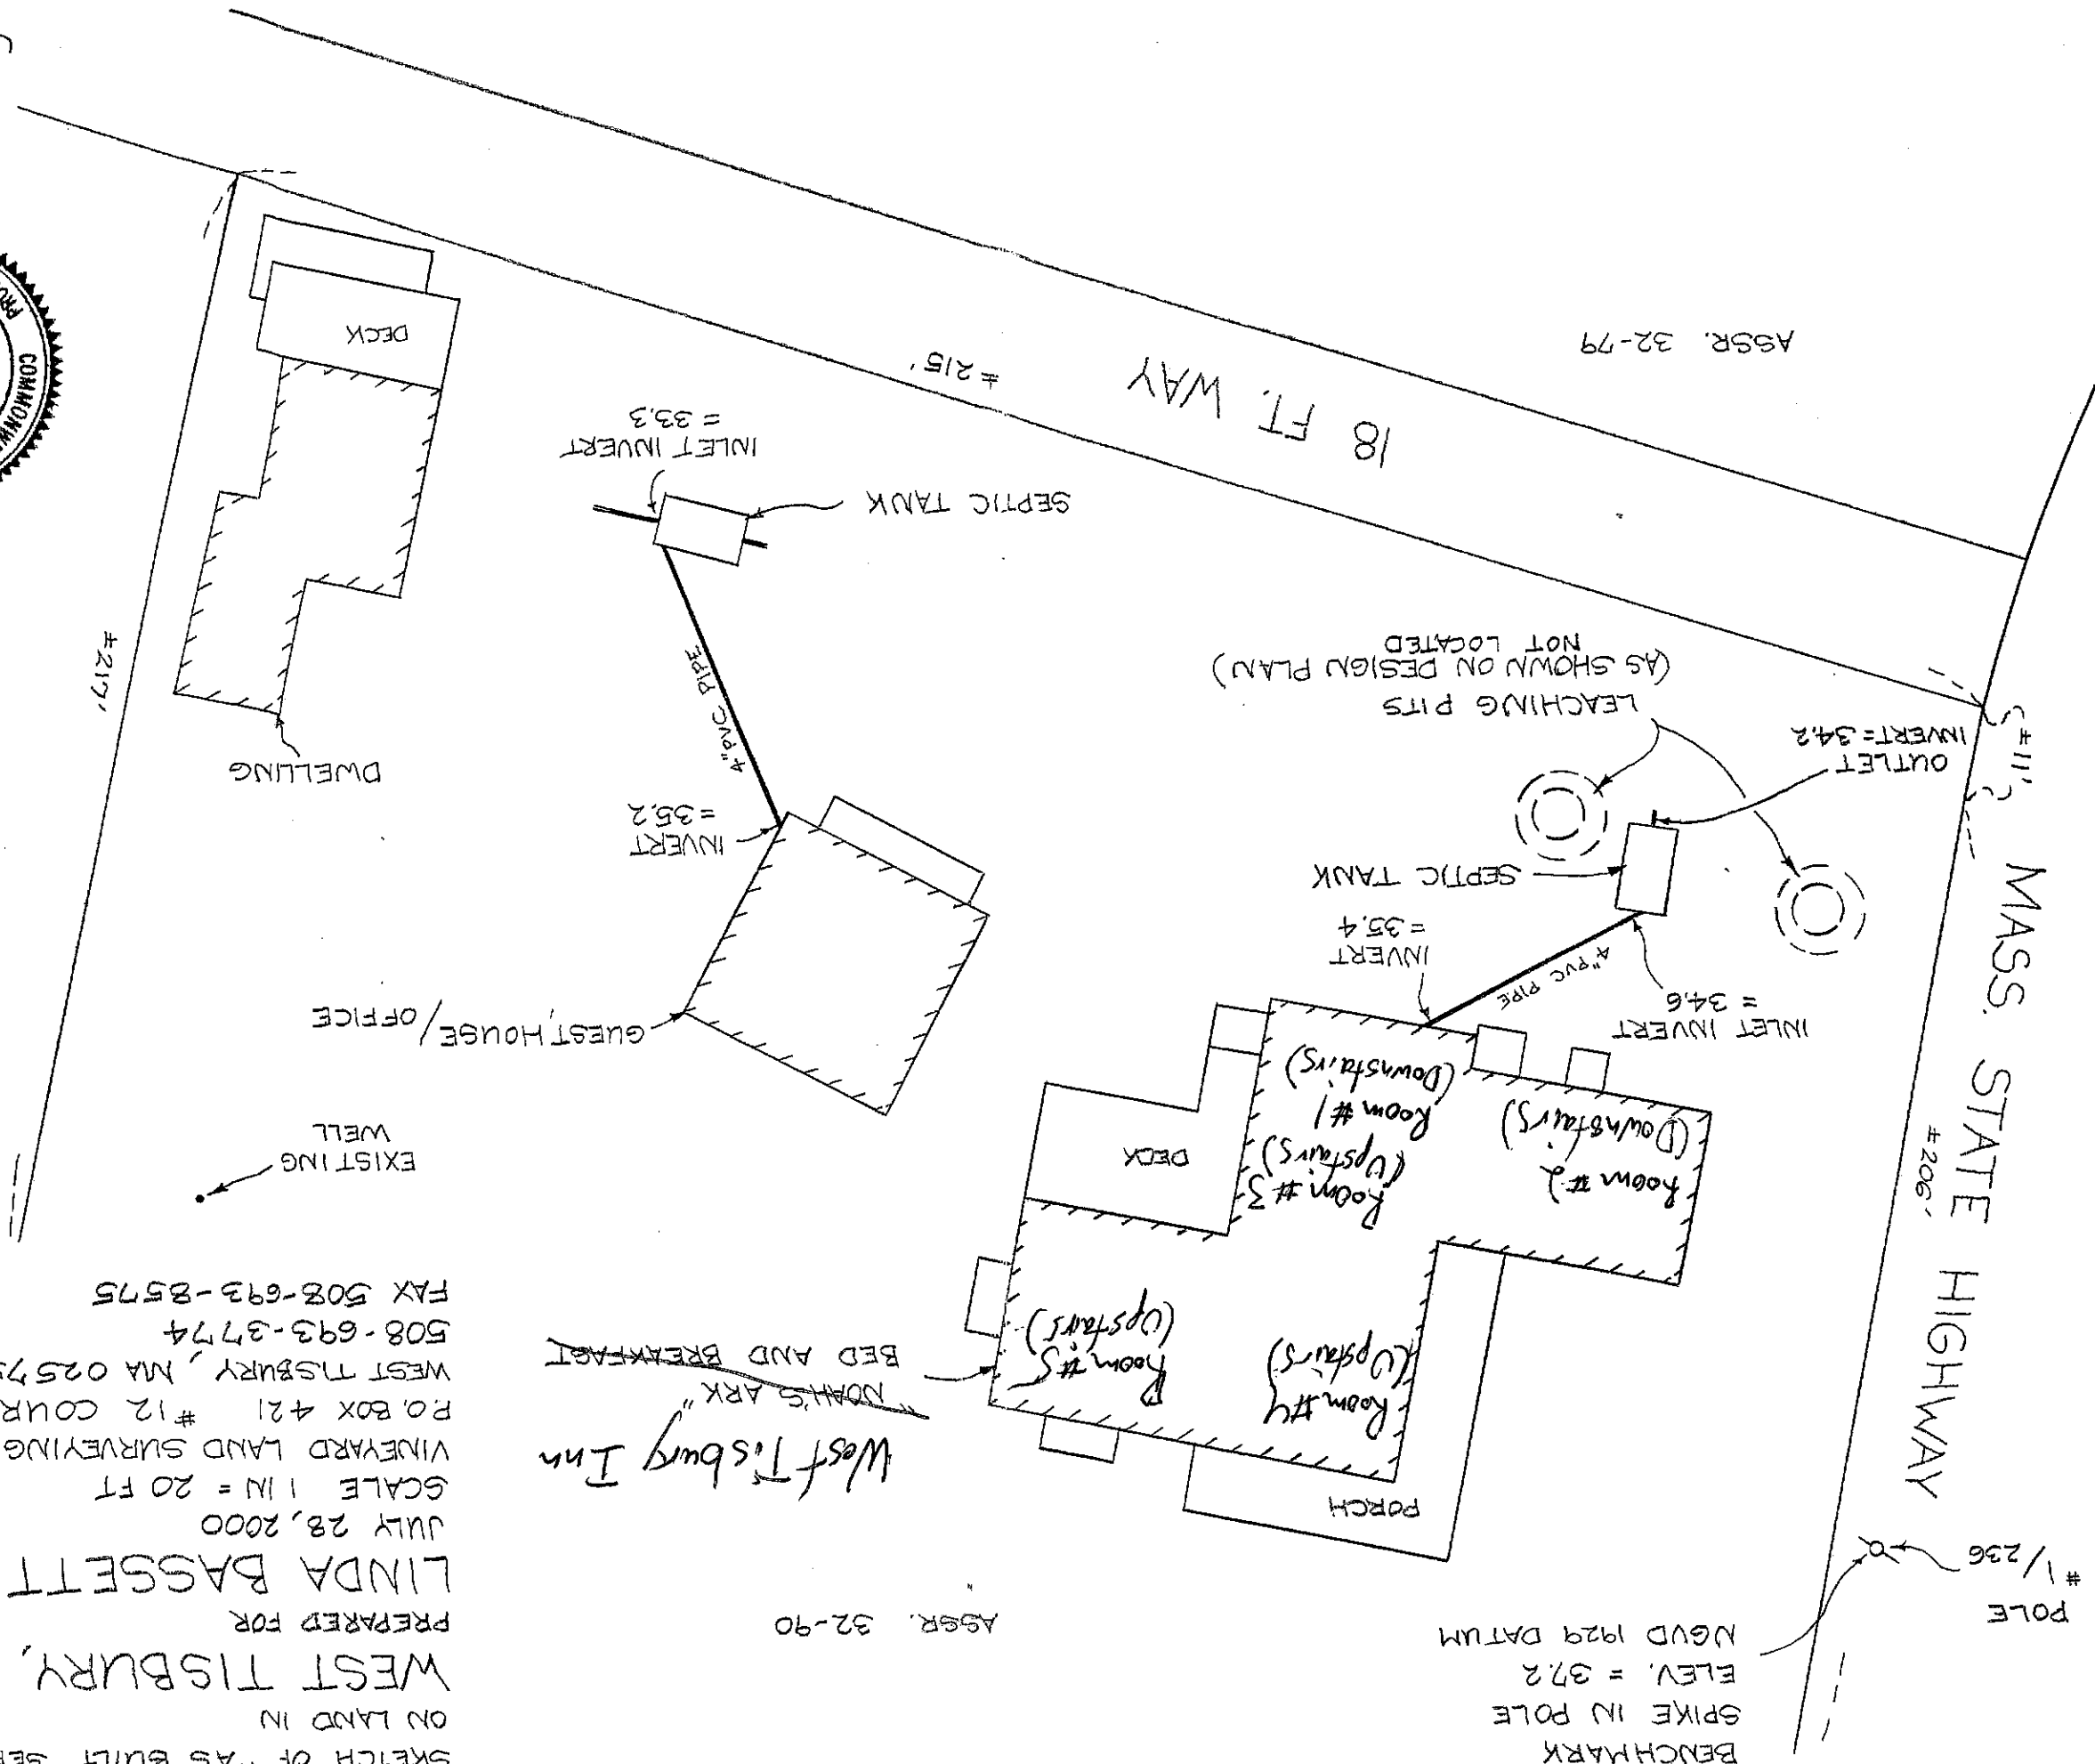

ASSR. 32-89

Received
8/23/00

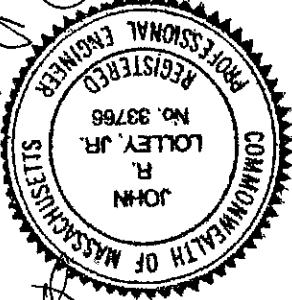

JOB 649