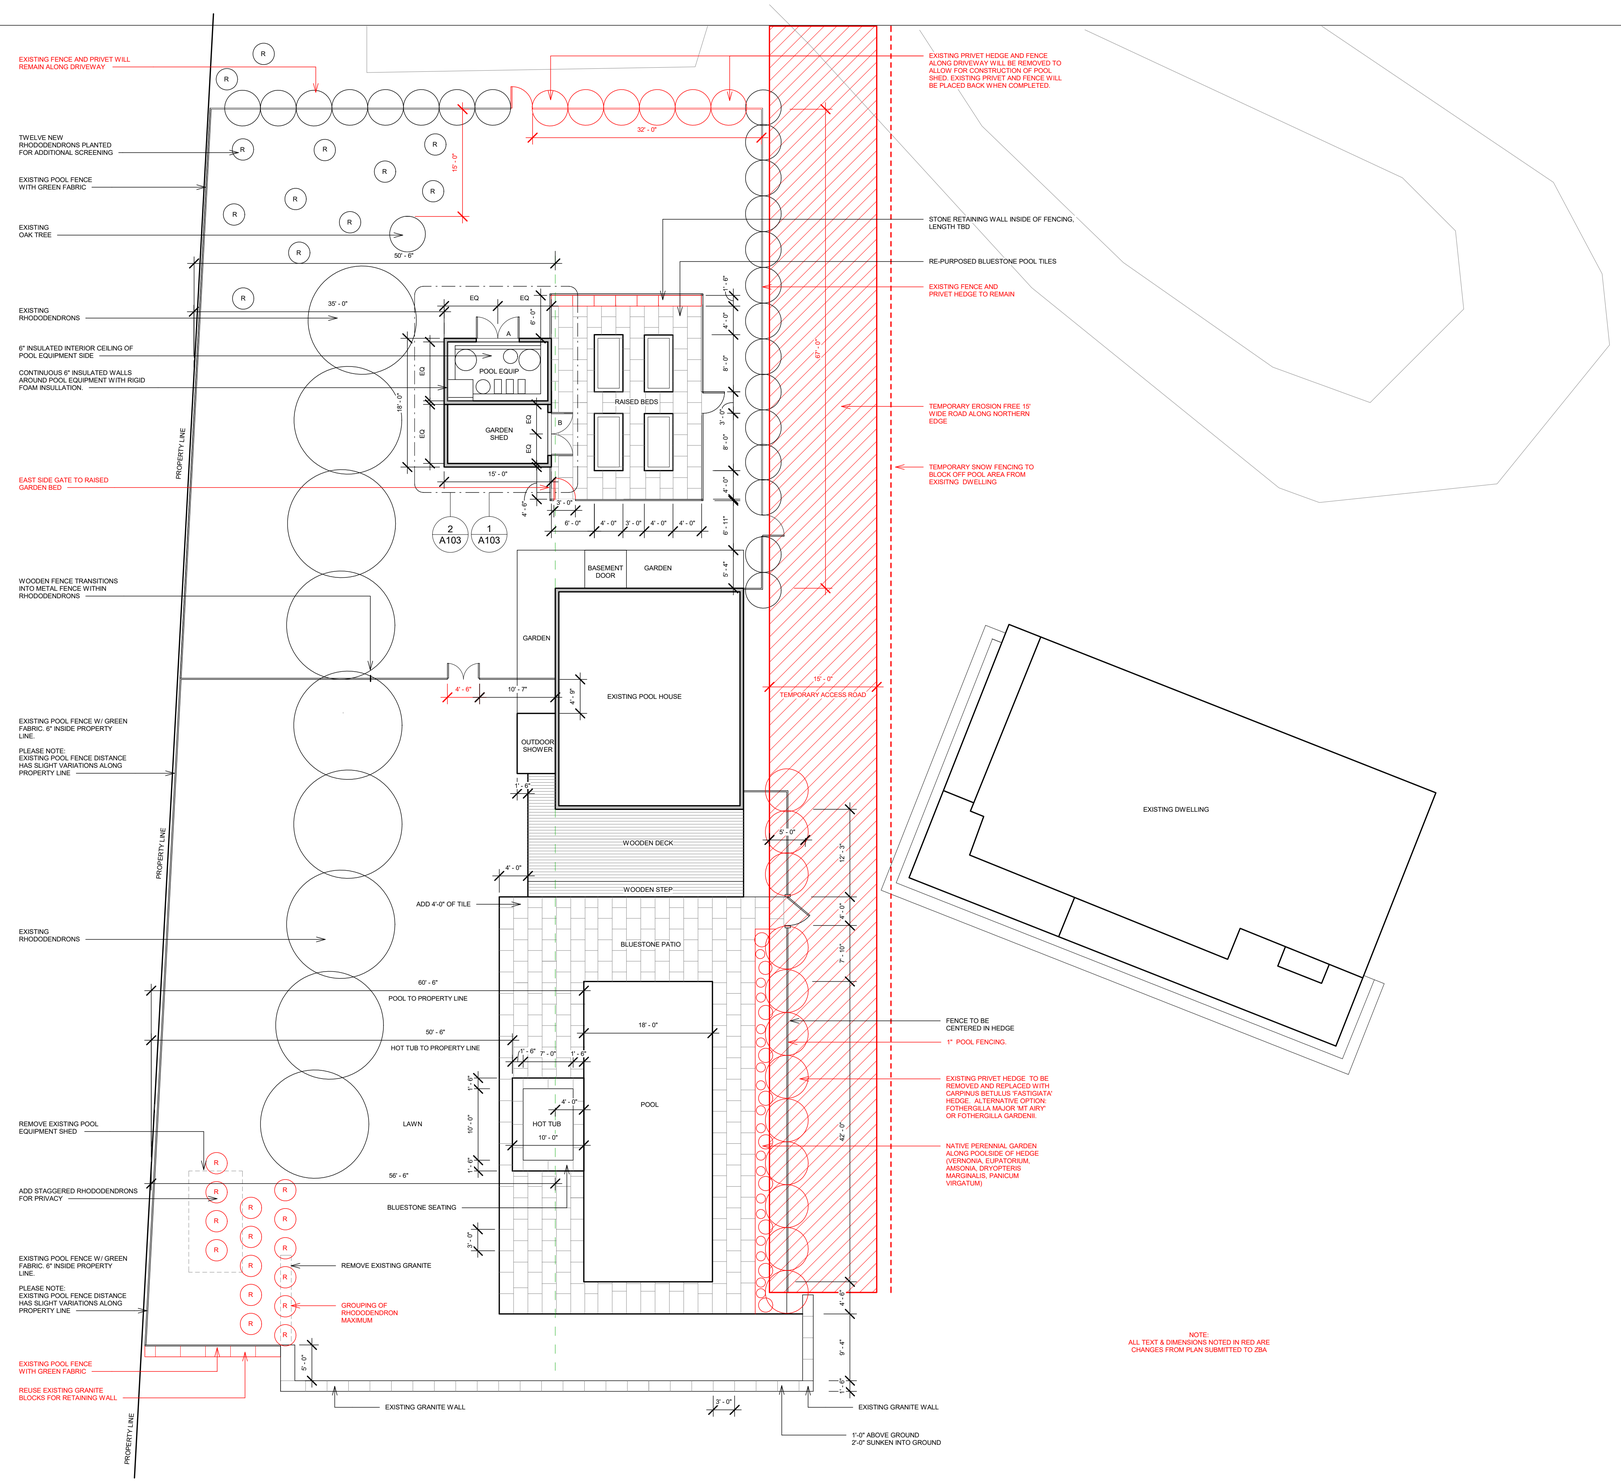

NOTE:
ALL TEXT & DIMENSIONS NOTED IN RED ARE CHANGES FROM PLAN SUBMITTED TO ZBA

1 SITE & SHED PLAN
1" = 10'-0"

VINEYARD GARDENS

www.vineyardgardens.net

Chuck Wiley
Vineyard Gardens Owner / Landscape Designer
484 State Rd. West Tisbury, MA 02575
(508) 693-8512
chuck@vineyardgardens.net

Karen Blackerby Logan
Designer
278 Capisic St. Portland, ME 04102
(858) 405-7500
karenblackerby@gmail.com

Russ Hartenstein
Pyramid Property Management
Project Manager
52 Carrolls Way Vineyard Haven
508-687-9049
russ@pyramidpm.com

Tekomah Goggins
Atlantic Pool, Inc.
PO Box 3507 Edgartown, MA 02539
508-627-7665
tekomah@atlanticpoolmv.com

No.	Description	Date

CARNEY RESIDENCE

80 Plum Rd West Tisbury, MA

SITE & SHED PLAN

Project number	Project Number
Date	02/07/2024
Drawn by	KBL
Checked by	CW

A100

Scale	1" = 10'-0"

2/7/2024 11:56:56 AM